


AREA: MVT-E	GRID SQUARE (S): 101-L24 25 K25 J25	GRID CO-ORDINATES: E N	INITIALS & DATE: DESD 1-iii-11	FEATURE No.: 33144									
FEATURE TYPE (For example wall, staircase, bench, foundation structure, platform etc.): WALL.			Full extent visible in plan: <del>YES</del> / (NO)										
1. Dimensions (in metres)		Length: 9,34 m.	Width: 2,18.	Height: 0,85 m.									
2. Type of material(s) used		Mudbrick (bubble gum / Nile clay and sandy bricks).											
3. Coursing (form of construction)		Header.											
4. Orientation		N/S.											
5. Associated collapse		32787											
6. Cut & fill feature #'s		/											
7. Repaired?		/											
8. Associated floors		/											
9. Surface treatments? E.g. plaster, paint, mouldings		/											
10. Size of one component		40 x 19 cm.											
11. Bonding material													
12. Excavated		<del>Yes</del> / No											
Mini stratigraphic matrix <table border="1" style="width: 100%; text-align: center;"> <tr> <td style="width: 30px; height: 30px;"></td> <td style="width: 30px; height: 30px;">+</td> <td style="width: 30px; height: 30px;"></td> </tr> <tr> <td></td> <td style="border: 1px solid black; padding: 2px;">33144</td> <td></td> </tr> <tr> <td style="width: 30px; height: 30px;"></td> <td style="width: 30px; height: 30px;"></td> <td style="width: 30px; height: 30px;"></td> </tr> </table>			+			33144					Abuts: 30249 (?) Same as: Abutted by: Associated features: Bonded into: Contiguous with:		
	+												
	33144												
Discussion and interpretation: Mudbrick wall associated with the mb. collapse (32787). Edge of the wall in the N part is not clear. It seems abutt the wall [30249] but need more investigations. Forms the eastern limits of MVT-E.													

Remember: do not just draw the architectural feature in isolation. Show how it relates to surrounding features and include details of surface treatments, repairs/modifications/damage, bonding material(s), and associated cuts. Annotate all aspects of the feature or use a Drawing Key. Measurements must be included for all aspects of the feature and surrounding features.

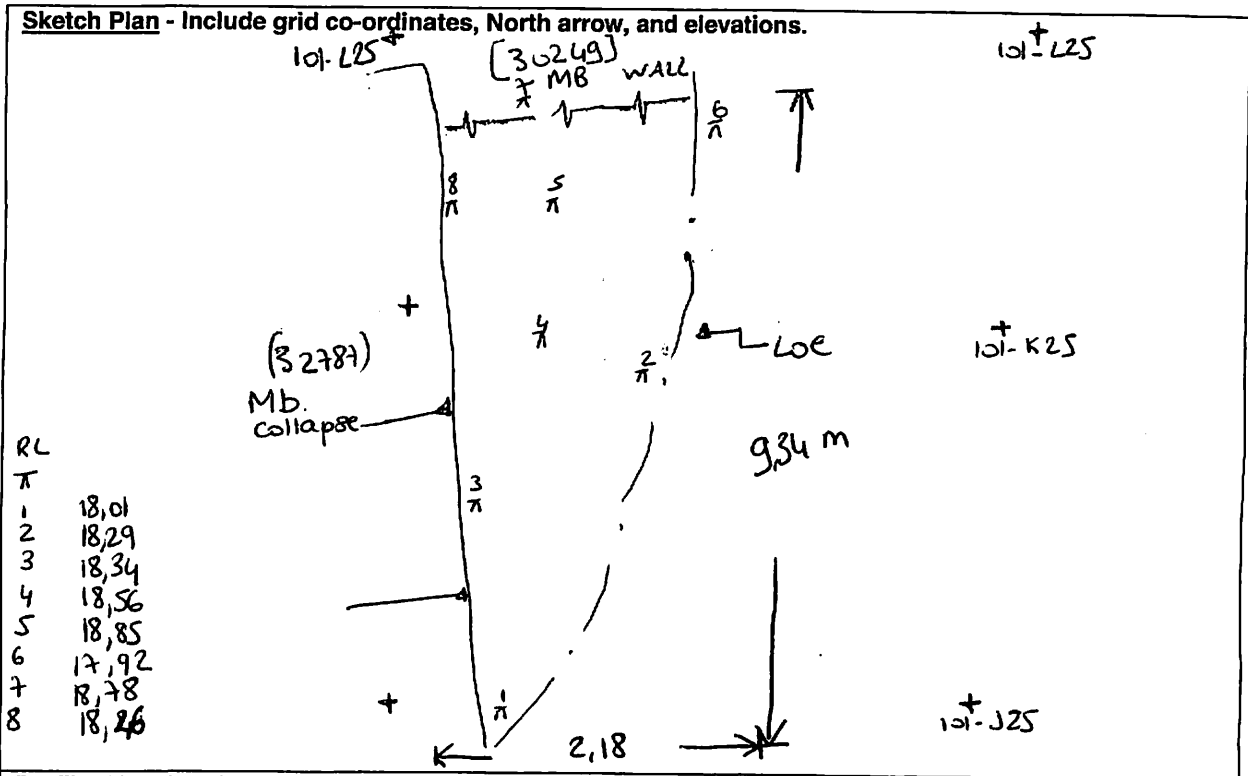

**Profile Sketch** - State direction the elevation of the feature being drawn is facing e.g. 'West Facing Elevation of Feature .... If feature was drawn in section then include the grid co-ordinates and elevations.

Drawing No.'s:	2011-81	Photo No.'s:	
Space No.:		Structure No.:	
Matrix Group:		Matrix Phase:	
Samples taken:			